


MIXED SEDIMENT NOURISHMENT


LONG BEACH, PLYMOUTH, MA
MAY 2023Prepared for:
Town of Plymouth, MAPrepared by:
Foth Infrastructure & Environment, LLC
&
Sustainable Coastal Solutions, Inc.

VICINITY MAP

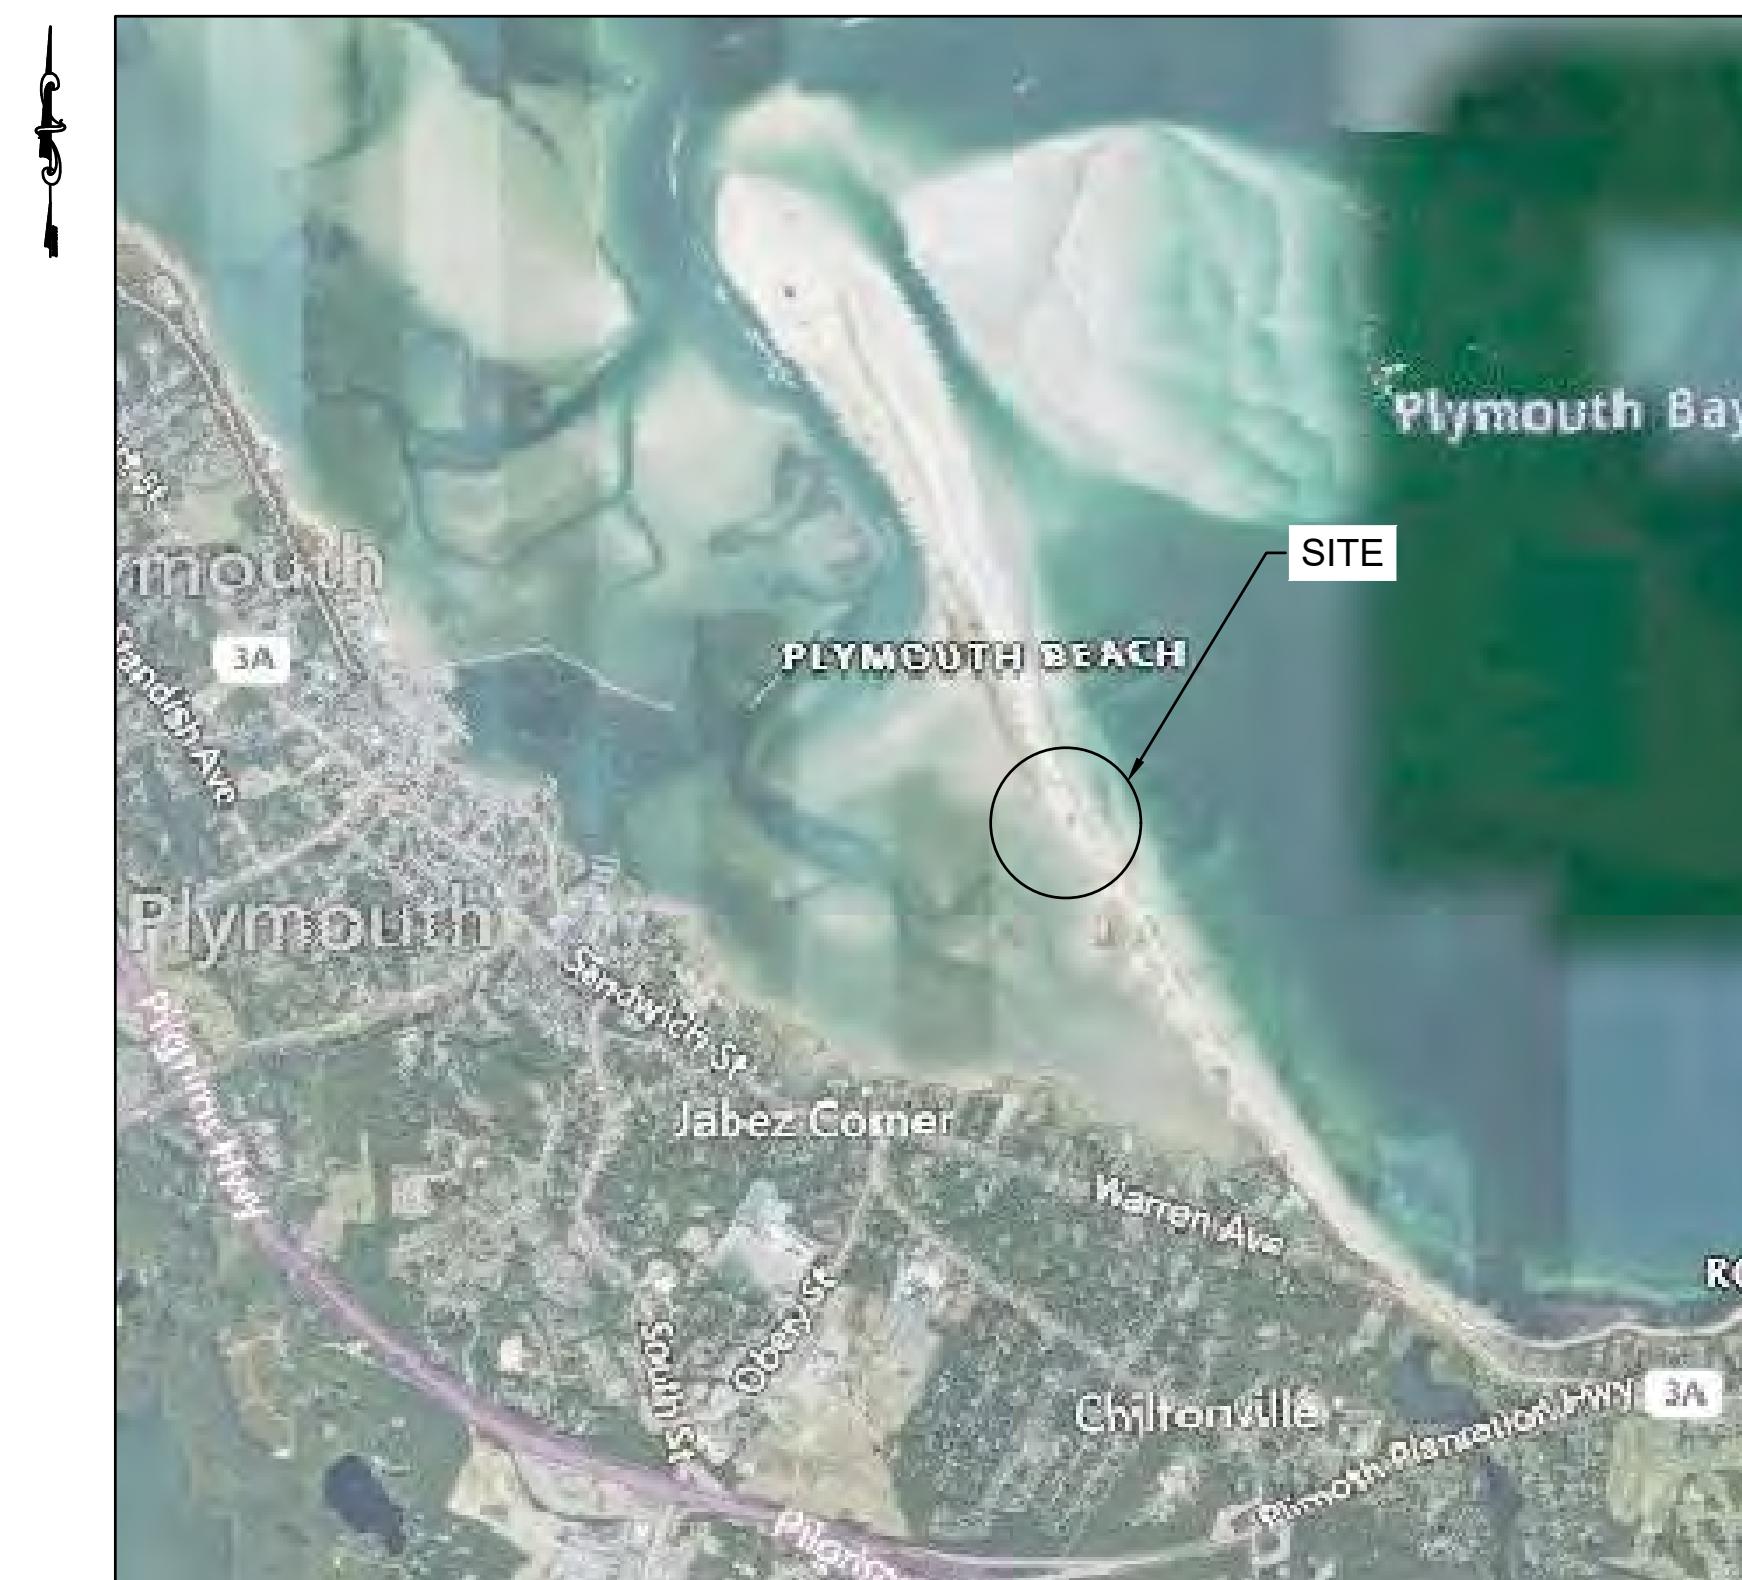


LOCATION MAP

DRAWING INDEX	
SHEET NUMBER	TITLE
C	COVER SHEET
1	SITE PLAN
2	CROSS SECTIONS

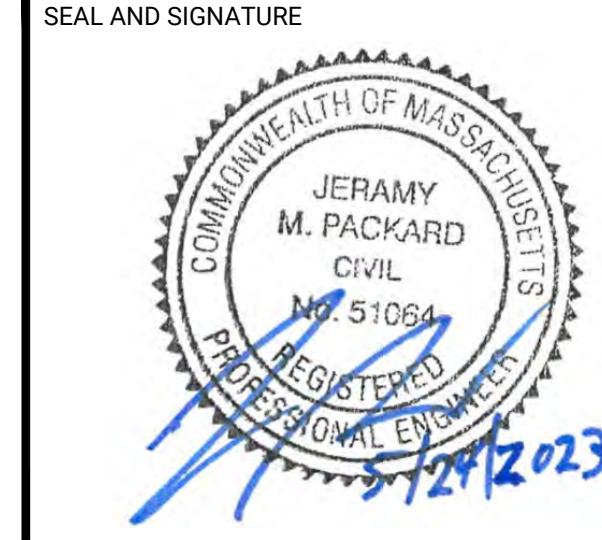SEAL AND SIGNATURE 	SHEET TITLE
	COVER SHEET
SHEET NUMBER	
C	

**TOWN OF PLYMOUTH, MA
LONG BEACH**

MIXED SEDIMENT NOURISHMENT

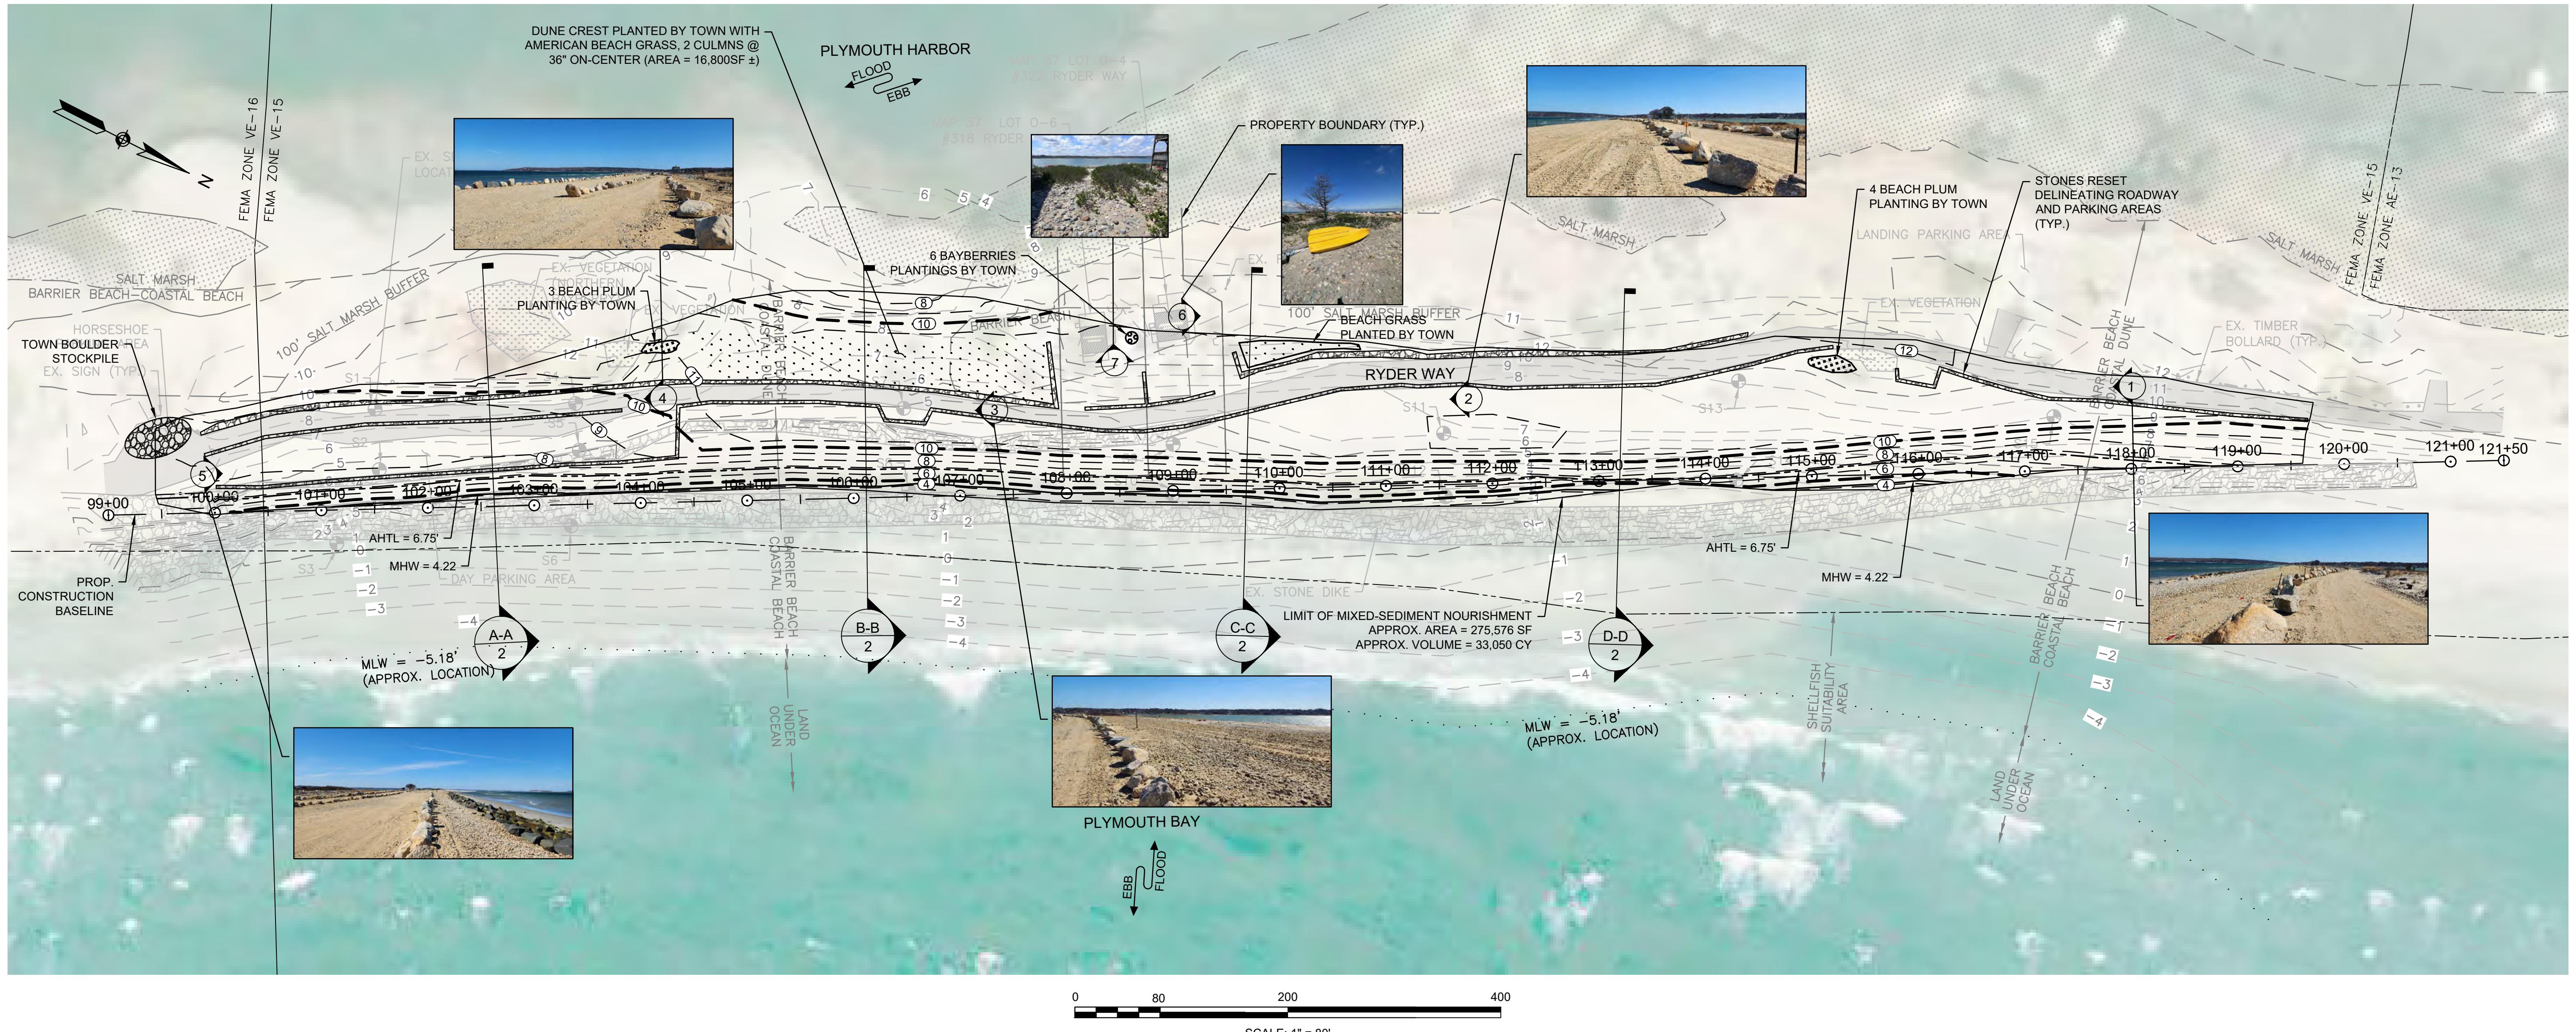

GENERAL NOTES:

1. TOPOGRAPHIC SURVEY INFORMATION SHOWN WAS COLLECTED BY FOTH INFRASTRUCTURE & ENVIRONMENT, LLC ON 4/3/2023.
2. THE TOWN OF PLYMOUTH IS PLANNING TO INSTALL ADDITIONAL BEACH GRASS PLANTINGS IN FALL 2023 TO MITIGATE DAMAGE TO NEWLY INSTALL PLUGS BY RABBITS IN SPRING 2023.
3. CONSTRUCTION ACTIVITIES OCCURRED BETWEEN 2/6/2023 - 3/31/2023.
4. PROPERTY LINES SHOWN WERE PROVIDED BY TOWN OF PLYMOUTH FOR USE ON THIS PROJECT.
5. A SHELLFISH SURVEY WAS PERFORMED BY THE TOWN OF PLYMOUTH ON 2/4/2021, AND A REPORT PREPARED BY THE PLYMOUTH DIVISION OF NATURAL RESOURCES. THE REPORT CONCLUDES THAT THERE IS MINIMAL SURF CLAM HABITAT BETWEEN MHW AND MLW AT THE PROJECT SITE.
6. ELEVATIONS SHOWN ARE IN US SURVEY FEET AND REFER TO THE NORTH AMERICAN VERTICAL DATUM OF 1988 (NAVD 88).
7. PROJECT AREA SHOWN LIES ENTIRELY WITHIN NHESP ESTIMATED/PRIORITY HABITAT AREA.
8. PROJECT AREA SHOWN LIES ENTIRELY WITHIN LAND SUBJECT TO COASTAL STORM FLOWAGE.
9. PROJECT AREA SHOWN LIES ENTIRELY WITHIN FEMA COASTAL BARRIER RESOURCE SYSTEM AREA (1/16/1990) AS SHOWN ON FIRM 25023C0359K EFFECTIVE DATE NOVEMBER 4, 2016.
10. POSSESSION AND USE OF THE MATERIAL CONTAINED ON THESE DRAWINGS IS GRANTED ONLY IN CONNECTION WITH ITS USE AS IT RELATES TO THE TITLED PROJECT, ANY OTHER USE, REPRODUCTION OR DISCLOSURE OF THE INFORMATION CONTAINED HEREIN IS EXPRESSLY PROHIBITED WITHOUT THE WRITTEN CONSENT OF FOTH INFRASTRUCTURE & ENVIRONMENT, LLC, AND THE TOWN OF PLYMOUTH.

© COPYRIGHT 2023, FOTH INFRASTRUCTURE & ENVIRONMENT, LLC.

REVISIONS		
NO	BY	DATE
1	JMP	(AS NOTED)
2	MDW	APRIL 2023
3	-	-
4	JMP	APRIL 2023

DATE OF PREPARATION		
NO	BY	DATE
1	JMP	(AS NOTED)
2	MDW	APRIL 2023
3	-	-
4	JMP	APRIL 2023

SHEET TITLE:		
NO	BY	DATE
1	JMP	(AS NOTED)
2	MDW	APRIL 2023
3	-	-
4	JMP	APRIL 2023

SITE PLAN

DATUM OFFSETS		
11.93	6.75	AHT
9.85	4.67	MHHW
9.40	4.22	MHW
5.18	0.00	NAVD 88

ISSUANCE:		
1	AS-BUILT	


PROJECT NO:		
1	21P030	

SHEET NUMBER		
1		

OFFSETS TAKEN FROM
VDATUM ONLINE ON 2/12/2021
FOR 41.9623N, -70.6364W

TOWN OF PLYMOUTH, MA
LONG BEACH

MIXED SEDIMENT NOURISHMENT

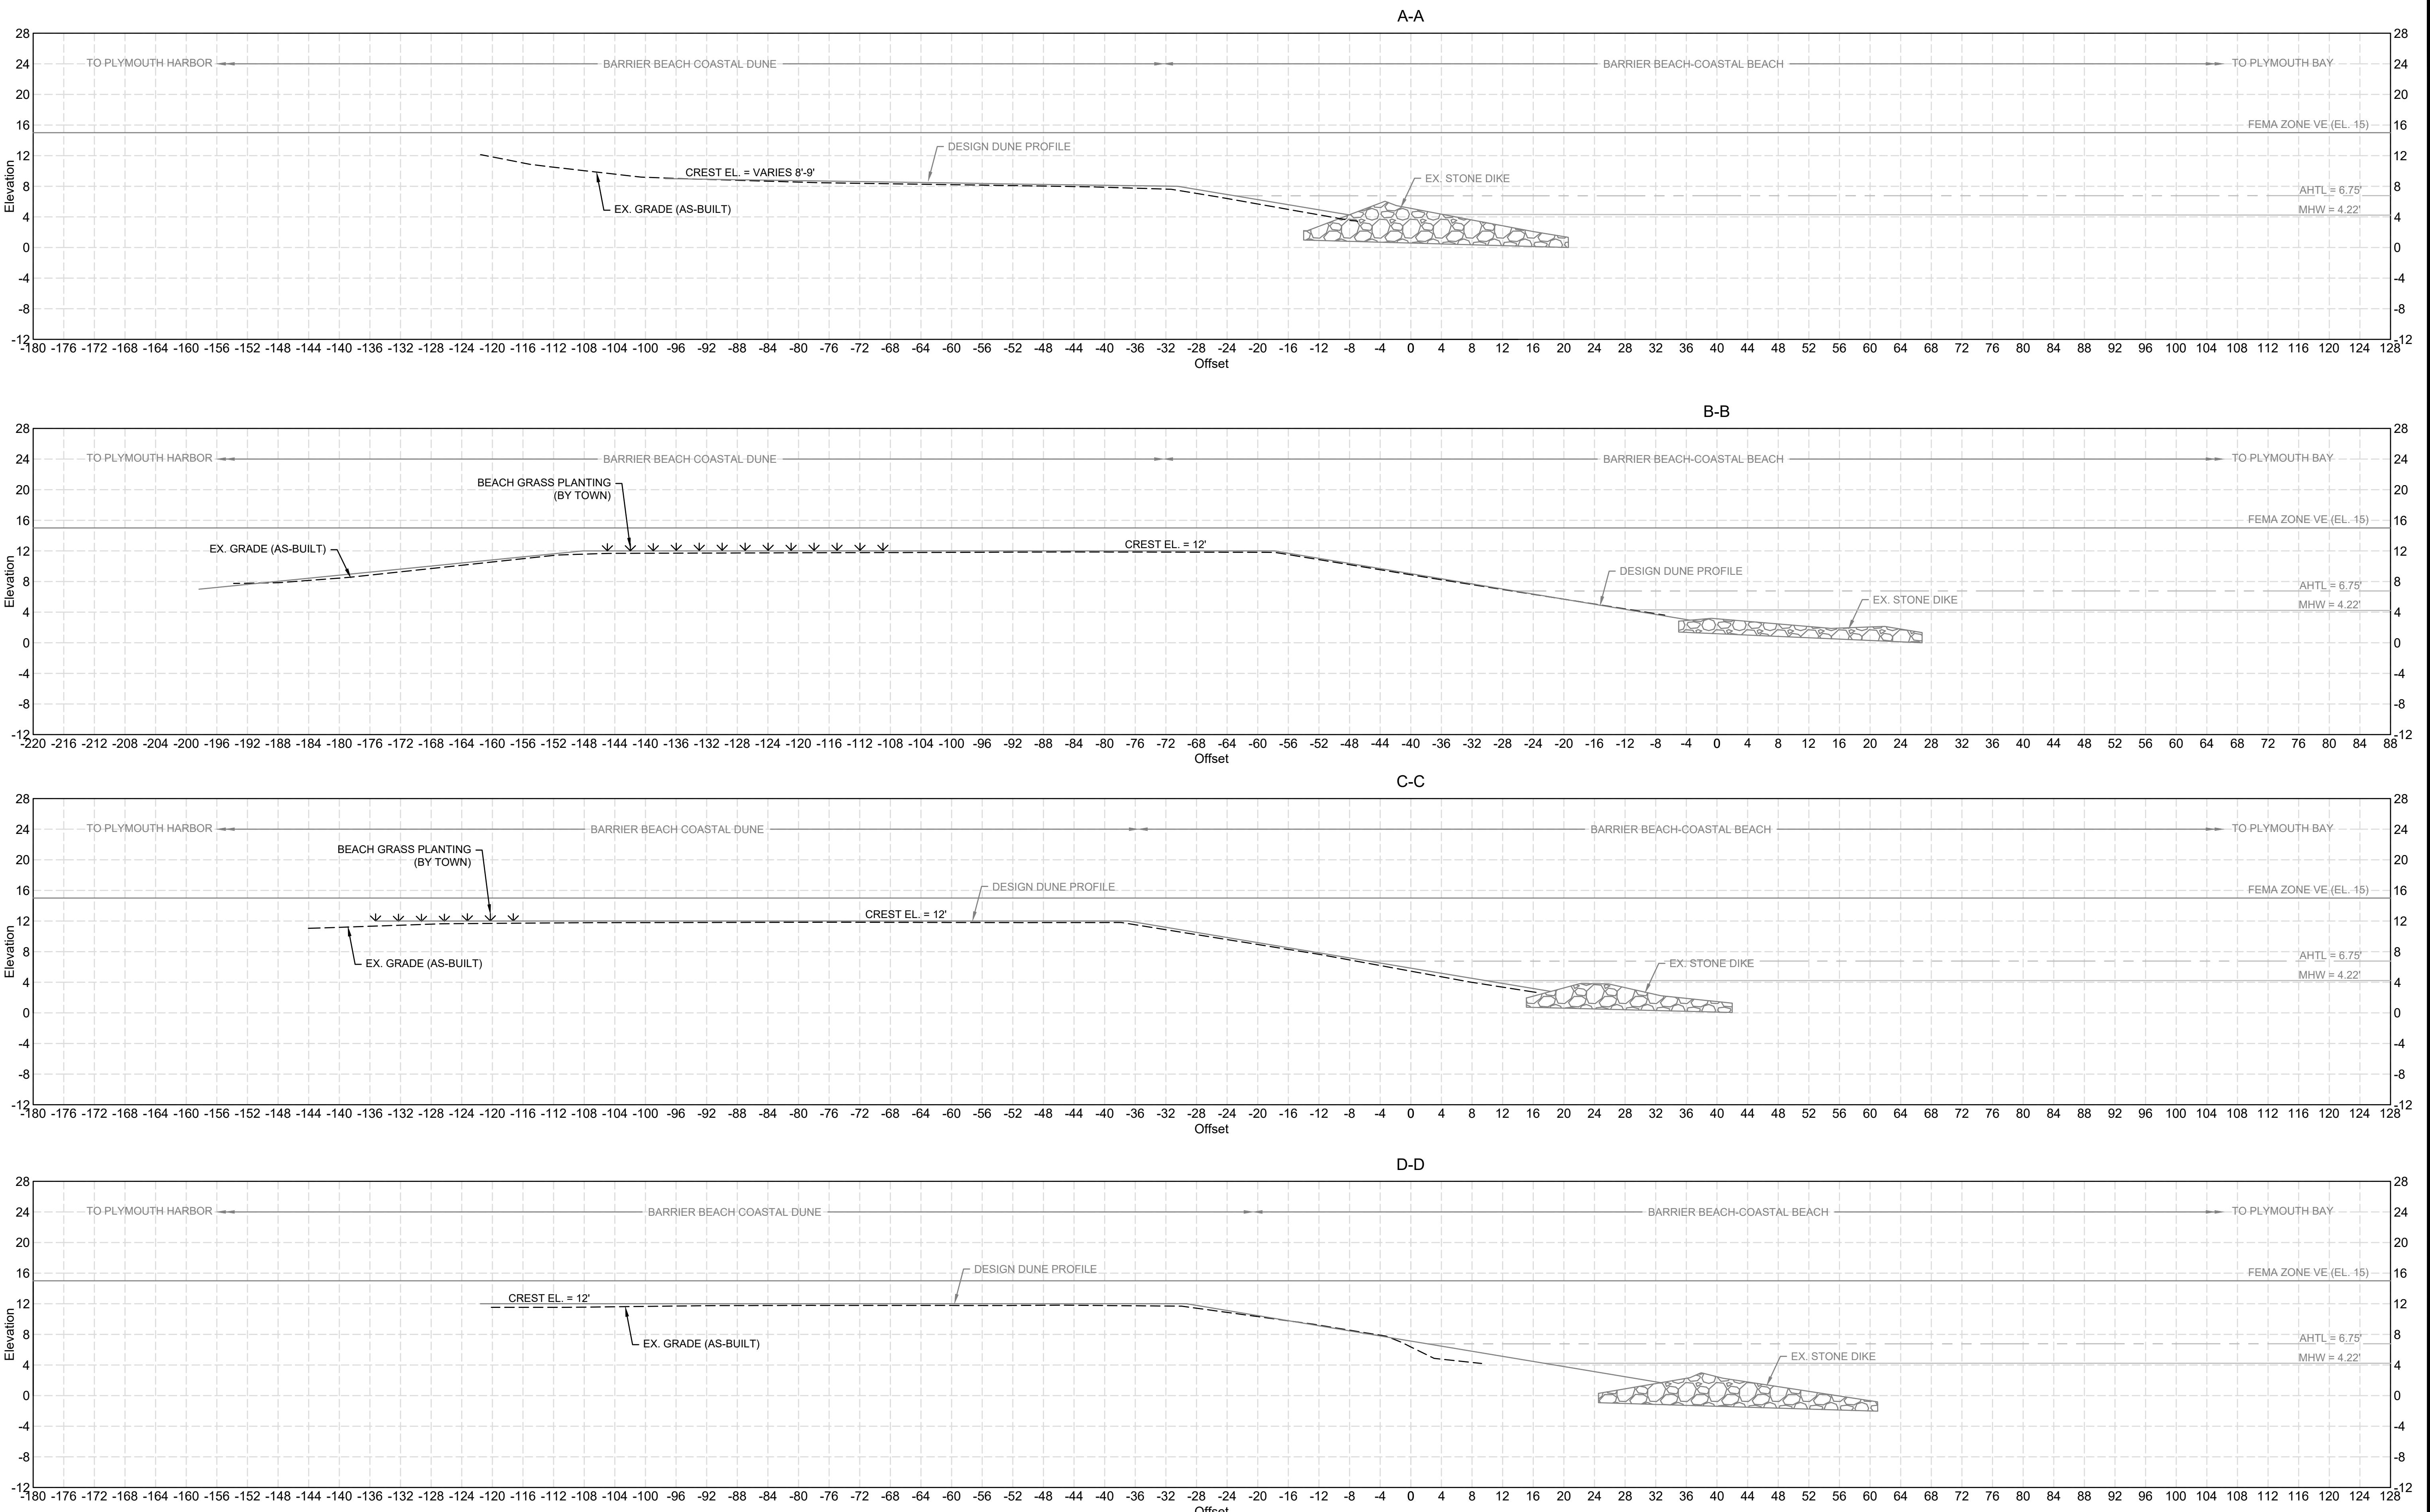

NO.	BY	DATE	REVISIONS	DESCRIPTION
1	JMP	(AS NOTED)		
2	MDW	APRIL 2023		
3	-	-		
4	JMP	APRIL 2023		

DATE OF PREPARATION		
BY	DATE	
SURVEYED	JMP	(AS NOTED)
DRAWN	MDW	APRIL 2023
DESIGNED	-	-
CHECKED	JMP	APRIL 2023

SHEET TITLE:

CROSS
SECTIONS

ISSUANCE:

AS-BUILT

PROJECT NO: 21P030

SHEET NUMBER